



- GENERAL NOTES:**
- SEE MASTER NOTES (SHEET AA) FOR ADDITIONAL INFORMATION.
 - ALL PENETRATIONS THROUGH FIRE RATED CONSTRUCTIONS SHALL BE SLEEVED FIRE SEALED AND PATCHED.
 - ALL PENETRATIONS THROUGH NON-FIRE RATED CONSTRUCTIONS SHALL BE SLEEVED PATCHED AND SEALED TO MATCH EXISTING.
 - THIS IS A DIAGRAMMATIC DRAWING AND SHALL NOT BE USED FOR PRECISE MEASUREMENTS.
 - ALL WORK SHALL CONFORM TO NECA, LOCAL, STATE, AND PORT AUTHORITY REQUIREMENTS.
 - SEE DRAWING T1 FOR CABLE SPECIFICATIONS.
 - ALL CABLE SHALL BE TAGGED AS TO TENANT AND SYSTEM IDENTITY.
 - ALL CONNECTIONS OR FUTURE INSTALLATIONS FROM AFS SUPPLIED ALARA BLOCKS SHALL BE DONE BY TENANT.
 - ALL CABLE SPECIFICATIONS SHALL BE APPROVED BY THE PORT AUTHORITY PRIOR TO PURCHASE AND INSTALLATIONS.

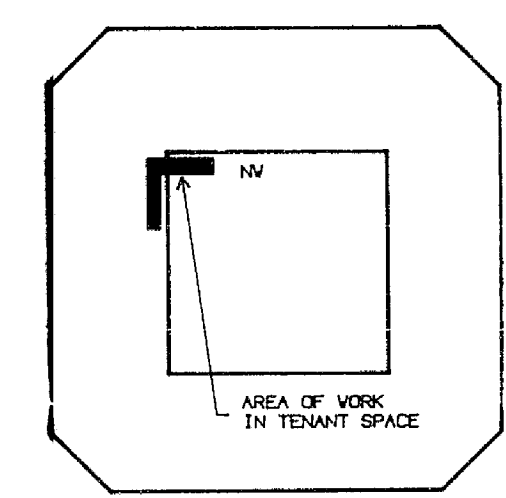

KEY PLAN
104TH FLOOR
NTS

AS-BUILT

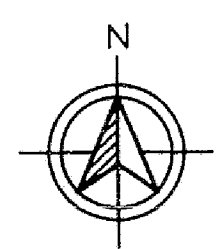

ONE WORLD TRADE CENTER
THE CANTOR FITZGERALD SECURITIES COMPANY
104th PARTIAL FLOOR PLAN - CABLE ROUTE IN TENANT SPACE
 SCALE: 1/8" = 1' 0"

SHEET NO.
T2

REVISION	DESCRIPTION	DATE	INITIAL
KIEWIT NETWORK TECHNOLOGIES, INC.			
TITLE METROPOLITAN FIBER SYSTEMS WORLD TRADE CENTER - TOWER A PROPOSED CABLE ROUTES		INFORMATION ON THIS DOCUMENT IS PROPRIETARY AND SHALL NOT BE USED, COPIED, REPRODUCED OR DISCLOSED IN WHOLE OR IN PART WITHOUT WRITTEN CONSENT OF KNT	
DRAWING NO. 07-012-1VT-P2-56-T2 PHASE 2 THE CANTOR FITZGERALD CO.		SCALE AS SHOWN	SIZE C
ORIGIN HT	DATE 8/24/92	DRAWN HT	DATE 8/24/92
APPROVED AL A	DATE 8/24/92		